

DIABLO COMMUNITY SERVICES DISTRICT
Creek Bank Stabilization - 2121 Alameda Diablo Project

ADDENDUM NO. 2

August 18, 2026

The Diablo Community Services District ("District") makes the following changes to the Contract Documents for the Creek Bank Stabilization - 2121 Alameda Diablo Project:

- **Updated Bid Schedule.** Page 18 of the Bid Documents (the page including Section A, Bid Schedule, in the Bid Form) is **DELETED** and **REPLACED** with the Page 19 attached hereto as **Attachment 1** ("Updated Bid Schedule"). Bidders shall use the Updated Bid Schedule.
- **Additional Landscaping Plans.** The Plans and Specifications attached as **Exhibit C, Drawings and Specifications**, in the Contract Documents are **DELETED** and **REPLACED** with the Plans and Specifications attached hereto as **Attachment 2** ("Updated Plans and Specifications"). Bidders shall utilize the Updated Plans and Specifications for the basis of their bids.

Unless otherwise stated herein, all other provisions of the Contract Documents remain unchanged.

Attachment 1

Updated Bid Schedule

[Begins on Following Page]

No.	ITEM DESCRIPTION	UNIT OF MEASURE	EST. QTY.	UNIT PRICE	ITEM COST
1	WILLOW STALKS / DPOTS	EA	10		
2	CALIFORNIA WILD ROSE (1 GALLON)	EA	12		
3	POTHOLE UNDERGROUND UTILITIES	LS	1		
4	TRAFFIC CONTROL SYSTEM	LS	1		
5	SITE PREPARATION / CLEAR & GRUB	LS	1		
6	PLANTER SOIL	CY	40		
7	REMOVE PICKET FENCE	LF	50		
8	PICKET FENCE	LF	50		
9	18" DIA X 36" DEEP GFRC PLANTERS	EA	12		
10	SOIL NAIL	LF	723		
11F	MINOR CONCRETE	CY	24		
12F	BAR REINFORCING STEEL (RETAINING WALL)	LB	3080		
13F	STRUCTURAL SHOTCRETE	CY	34		
14	MOBILIZATION AND CONTRACT PROCESSING COST	LS	1		

TOTAL _____

"F" Denotes a Final Pay Item.

Attachment 2
Updated Plans and Specifications

[Begins on Following Page]

INDEX TO PLANS

SHEET	TITLE
T-1	TITLE SHEET
L-1	PLANTING PLAN
L-2	PLANTING NOTES
S-1	GENERAL PLAN
S-2	SOIL NAIL LAYOUT
S-3	SOIL NAIL WALL DETAILS No. 1
S-4	SOIL NAIL WALL DETAILS No. 2
S-5	SPECIAL PROVISIONS No. 1
S-6	SPECIAL PROVISIONS No. 2

THIS DESIGN HAS BEEN PREPARED BY BIGGS CARDOSA ASSOCIATES INC. ("CONSULTANT") FOR THE DIABLO COMMUNITY SERVICES DISTRICT ("DISTRICT") STRICTLY IN ACCORDANCE WITH THE PROFESSIONAL SERVICES AGREEMENT DATED JULY 9, 2026 (CONTRACT NO. 38200.00001\45214130.1). THE TOTAL REPAIR SCOPE IS PREDETERMINED BY CONTRACT LIMITATION NO. 5 AND IS RIGIDLY RESTRICTED TO A SPECIFIC 30-FOOT REPAIR SEGMENT ALONG THE CREEK BANK. CONSULTANT ASSUMES NO RESPONSIBILITY OR LIABILITY FOR SLOPE, EMBANKMENT, OR CHANNEL STABILITY BEYOND THESE PRE-DEFINED 30-FOOT PHYSICAL BOUNDS.

IN ACCORDANCE WITH THE U.S. ARMY CORPS OF ENGINEERS (USACE) NATIONWIDE PERMIT (CORPS FILE NO. AF NWP 13 SPN 2023-00252), TOE-KEY CONSTRUCTION BELOW THE ORDINARY WATER SURFACE ELEVATION IS STRICTLY PROHIBITED. CONSEQUENTIAL TO THIS REGULATORY PERMIT RESTRICTION, THIS PERMANENT REPAIR DESIGN CONSISTS SOLELY OF INSTALLING SOIL NAILS AND A SHOTCRETE OR WIRE MESH FACING ON THE PRE-EXISTING TEMPORARY REPAIR ROCK SLOPE PROTECTION (RSP) WITHOUT A DEEP STRUCTURAL TOE-KEY. THE DISTRICT AND CONSTRUCTING CONTRACTOR ACKNOWLEDGE THAT NO STRUCTURAL KEY HAS BEEN DESIGNED AT THE TOE DUE TO THIS PERMIT PROHIBITION.

PER CONTRACT LIMITATIONS NO. 4 AND NO. 6, THE CONSULTANT'S SCOPE OF WORK EXPLICITLY EXCLUDES THE DETERMINATION OF ORIGINAL RSP TYPE, SIZING, PLACEMENT METHOD, OR PHYSICAL BOUNDARIES. THIS DESIGN DOES NOT INCLUDE COMPREHENSIVE WATERSHED MODELING, SCOUR ANALYSIS, HYDROLOGY ANALYSIS, OR CHANNEL HYDRAULIC CALCULATIONS TO VERIFY THE ADEQUACY OF THE EXISTING REPAIR. CONSULTANT BEARS NO RESPONSIBILITY OR LIABILITY FOR CLAIMS, DAMAGES, OR DEMANDS ARISING FROM LOCALIZED OR REGIONAL HYDRAULIC IMPACTS.

THIS STRUCTURAL REPAIR DESIGN RELIES ENTIRELY ON GEOTECHNICAL DESIGN PARAMETERS AND DATA PROVIDED BY THE DISTRICT'S GEOTECHNICAL ENGINEER OF RECORD (ENGEOR OR OTHER). PER LIMITATION NO. 1, THE GEOTECHNICAL ENGINEER MAINTAINS SOLE PROFESSIONAL RESPONSIBILITY FOR CONFIRMING GLOBAL SLOPE STABILITY COMPONENTS AND EMBANKMENT SOIL ANCHOR LAYOUT CHARACTERISTICS. CONSULTANT HAS NOT INDEPENDENTLY VERIFIED, AND ASSUMES NO LIABILITY FOR, THE ACCURACY OF PRE-EXISTING GEOTECHNICAL AND GEOPHYSICAL BOUNDARY DATA PROVIDED BY OTHERS.

NOTICE IS HEREBY GIVEN THAT THE COMPLETED RSP REPAIR IMPROVEMENTS MAY ALTER LOCALIZED CHANNEL HYDRAULICS AND DETRIMENTALLY AFFECT THE STABILITY OF ADJACENT AND OPPOSITE UNIMPROVED CREEK EMBANKMENTS. ALTERED HYDRAULIC FLOWS MAY INDUCE FUTURE CREEK EMBANKMENT FAILURES, SLIDES, SLUMPS, OR SCOUR OCCURRING UPSTREAM OR DOWNSTREAM OF THE 30-FOOT REPAIR BOUNDARY. PER CONTRACTUAL REQUIREMENT, THE DISTRICT ACCEPTS SOLE RESPONSIBILITY FOR BROADER CREEK STABILITY. THE DISTRICT SHALL INDEPENDENTLY CONTRACT WITH A QUALIFIED HYDRAULICS CONSULTANT TO PERFORM COMPREHENSIVE WATERSHED AND CHANNEL STABILITY ANALYSES BASED ON THESE FINAL REPAIR DELIVERABLES. THE DISTRICT MAINTAINS SOLE EXPEDITED RESPONSIBILITY TO DESIGN, FUND, AND EXECUTE ANY RESULTING OUT-OF-SCOPE CREEK STABILIZATION OR MITIGATION MEASURES REQUIRED UPSTREAM OR DOWNSTREAM TO CONTAIN LIABILITIES FROM ALTERED FLUID DYNAMICS.

PER THE GEOTECHNICAL ENGINEERING RECOMMENDATIONS PROVIDED BY THE DISTRICT'S GEOTECHNICAL ENGINEER OF RECORD (ENGEOR OR OTHER), HIGHLY CORROSIVE SOIL CONDITIONS ARE PRESENT AT THE PROJECT SITE. THIS STRUCTURAL SPECIFICATION AND DESIGN CONFORMS STRICTLY TO THE MINIMUM CORROSION MITIGATION MEASURES, MATERIAL COATINGS, AND PROTECTION CRITERIA SPECIALLY SPECIFIED BY SAID GEOTECHNICAL ENGINEER FOR SOIL NAILS, ANCHOR HEADS, WIRE MESH, AND REINFORCING COATINGS. CONSULTANT HAS NOT INDEPENDENTLY TESTED OR EVALUATED THE SITE'S CHEMICAL OR ENVIRONMENTAL PROPERTIES AND BEARS NO LIABILITY FOR PREMATURE MATERIAL DEGRADATION, STRUCTURAL FATIGUE, OR FAILING SYSTEM INTEGRITY ARISING FROM CORROSIVE SOIL INTERACTIONS, CHEMICAL ATTACK, EXTREME GROUNDWATER FLUCTUATIONS, OR SYSTEM DEVIATIONS CAUSED BY INACCURATE OR INCOMPLETE GEOTECHNICAL DATA PROVIDED BY OTHERS.

NOTE:
THE CONTRACTOR MUST VERIFY ALL
CONTROLLING FIELD DIMENSIONS BEFORE
ORDERING OR FABRICATING ANY MATERIAL

Design: AASHTO LRFD Bridge Design Specifications
2017 Edition with California Amendments,
Updated September 2025

FHWA Publication No. FHWA-NHI-14-007
"GEOTECHNICAL ENGINEERING CIRCULAR No. 7 -
SOIL NAIL WALLS"

Live Load surcharge: 250 lb/ft² applied 2ft behind wall

Seismic Load: Horizontal seismic coefficient: $K_h = 0.24$

Soil Parameters:

DEPTH ** (ft)	UNIT WEIGHT (pcf)	FRICTION ANGLE (degrees)	COHESION (psf)	TEST LOAD PER UNIT LENGTH OF BOND, Q_b (lb/ft)
0-23	125	30	50	3392
Below 23*	130	28	0	3392

* Assumed Creek Flow elevation from the OG

** MEASURED FROM OG ALONG TOP OF WALL

Structural Shotcrete: $f'_c = 3.6 \text{ ksi}$
 $f_y = 60 \text{ ksi}$ (yield strength of reinforcement)
 $f_y = 65 \text{ ksi}$ (yield strength of welded wire)

Structural Steel: Grade 50 ($f_y = 50$ ksi)

Welded Studs: AWS 1.5, Type B ($f_u = 65$ ksi)

Soil Nails: Grade 75 ($f_y = 75 \text{ ksi}$)

BOW	BOTTOM OF WALL
OG	ORIGINAL GRADE
RSP	RSP
TOW	TOP OF WALL

Professional Engineer Seal for Ronald L. DeRudder, State of California, License No. 46945, Expires 9/30/27.

[illegible]

865 The Alameda
San Jose, CA 95126
T. 408.296.5515
www.biggscardosa.com




TITLE SHEET	2121 ALAMEDA DIABLO AVENUE CREEK EMBANKMENT STABILIZATION	DIABLO CALIFORNIA
-------------	--	----------------------

SHEET NUMBER	T-1
1 OF 9 SHEETS	
DRAWING NO.	2026301-1

2026301	(2026301T-1)
---------	--------------



PROPOSED PLANT PALETTE							
SYMBOL	BOTANICAL NAME	COMMON NAME	QTY.	MINIMUM CONTAINER SIZE	HxW EXPECTED MATURE SIZE	WUCOLS	TREE SIZE
TREES							
	SALIX LASIOLEPIS	ARROYO WILLOW	10	WHIPS OR D POTS	21' X 15'	H	S
SHRUBS							
	ROSA CALIFORNICA	CALIFORNIA WILDROSE	12	WHIPS OR D POTS	8' X 8'	L	X
NOTES: 1. ALL PLANTING MATERIAL TO BE RESOURCED FROM THE LOCAL WATERSHED BY A LANDSCAPE NURSERY PROPAGATING FROM SAID WATERSHED.							

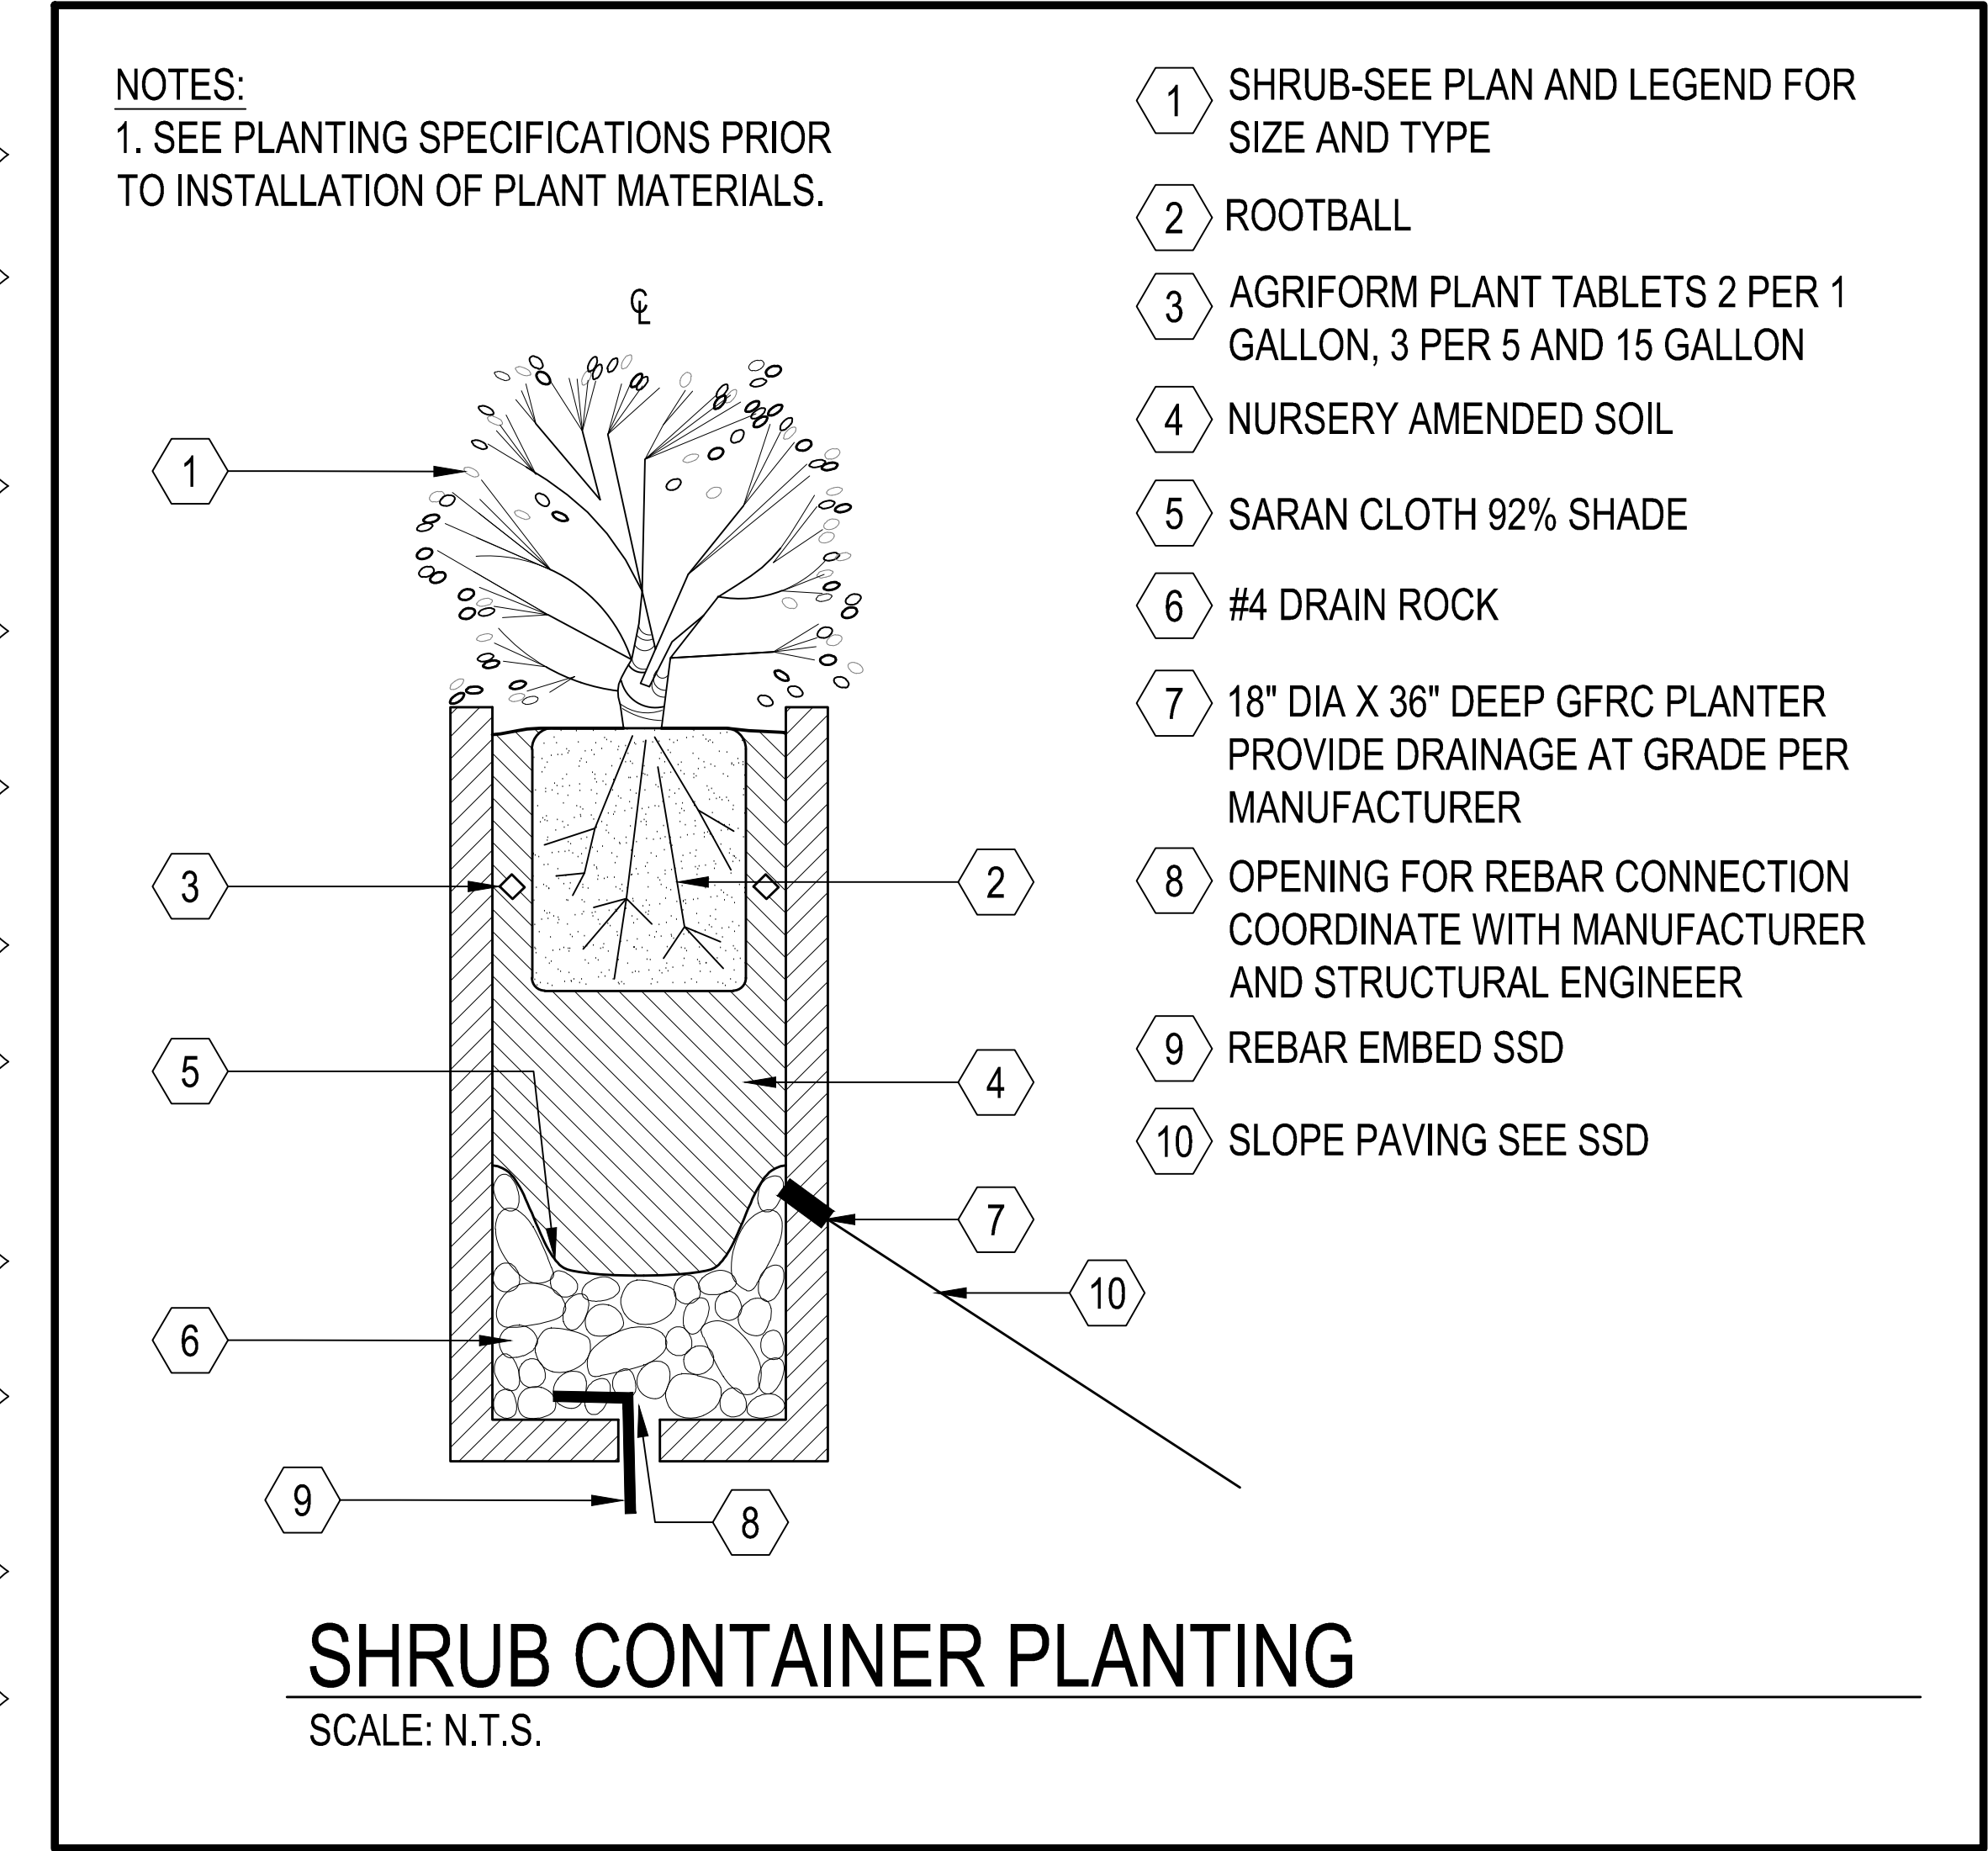

DESIGNED BY:

DRAWN BY: LK

CHECKED BY: WBS

SCALE: N.T.S.

BY

REV

DATE

DESCRIPTION

1570 Oakland Road
San Jose, CA 95131
T. 408.487.2200
www.hmhca.com

PLANTING PLAN
2121 ALAMEDA DIABLO AVENUE
CREEK EMBANKMENT STABILIZATION

SHEET NUMBER
OF SHEETS
DRAWING NO.
2 OF 9


2026301

LANDSCAPE ARCHITECT
NO. 4406
STATE OF CALIFORNIA
LUCAS W. WILLIAMSON
Signature
Expiry Date

8/17/2026
8/10/2026
ADDENDUM 1
ISSUED FOR BID

PLANTING PLAN NOTES

- A. GENERAL
 - Contractor shall provide all labor, materials and equipment for the installation of plant material as indicated on the drawings and as specified herein.
 - Contractor shall coordinate planting with other site improvements. Unless otherwise specified, structural improvements shall be installed prior to planting operations.
 - Contractor shall be responsible for locating and staking existing sewer, water and utility lines above or below grade that might be damaged as a result of planting operations. Contractor shall assume sole responsibility for any cost incurred due to damage and for replacement of aforementioned utilities.
 - Samples of fertilizers, soil conditioners, seed, or other materials shall be submitted to Owner forty-eight (48) hours prior to incorporation in the work.
 - Any agricultural suitability and fertility analysis soils report shall take precedence over these specifications.
- B. PLANT MATERIAL QUALITY
 - Plant material shall be in accordance with the State Department of Agriculture's regulations for nursery inspections, rules and grading. All plants shall be of No. 1 Grade and have a normal habit of growth, and shall be sound, healthy, vigorous and free of insect infestations, plant diseases, sun scalds, fresh bark abrasions or other objectionable disfigurements. All plants shall have a normal, well-developed branch system and vigorous and fibrous root system which is not root bound and is free of kinked or girdling roots.
 - Nursery growth stock shall be selected from high quality, well-shaped stock, grown under climatic conditions similar to those in the project locale. Minimum acceptable size of plants as indicated in the drawings shall correspond with that normally expected for the species and variety of commercially available nursery stock.
 - Oversize plants may be used if not root bound, but shall not increase the Contract price. Up to ten percent (10%) of undersized plants in any one (1) variety and grade may be used, provided they are larger than the average size of the next smallest grade.
 - Scientific and common names conform to customary nursery usage.
 - Types and sizes of plant materials shall be as indicated on the drawings. Quantities shown are a guide only, Contractor shall verify quantities by plan check.
 - The Owner reserves the right to refuse or reject any unsuitable plant material. Unsuitable plants shall be removed from the project site and replaced at the Contractor's expense. Replacement plants shall be the same species, variety, size and conditions as specified.
 - Pruning of plant materials shall not be done prior to delivery. After planting, pruning shall be limited to the minimum necessary to remove injured twigs and branches, dead wood and suckers.
 - Plant material is subject to substitution based upon availability. Substituted material shall be approved in advance by the Owner.
- C. GUARANTEE
 - Contractor shall guarantee plant material through one (1) full year after the date of acceptance of the work.
 - Replacement plant material shall be of the same species, variety, & size as originally planted and shall be guaranteed for one (1) full year from the date of re-planting.
 - Cost incurred due to replacement of dead or dying plant material shall be the responsibility of the Contractor.

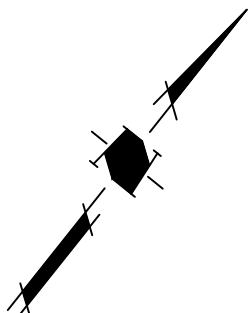

PLANTING SPECIFICATIONS

2121 ALAMEDA DIABLO AVENUE
CREEK EMBANKMENT STABLIZATION

SHEET NUMBER
L-2
OF SHEETS

DRAWING NO.
3 OF 9


1570 Oakland Road
San Jose, CA 95131
T. 408.487.2200
www.hmhca.com

DESIGNED BY:
DRAWN BY:
CHECKED BY:
SCALE:
BY

ADDENDUM 1
ISSUED FOR BID

REV DATE

N.T.S.


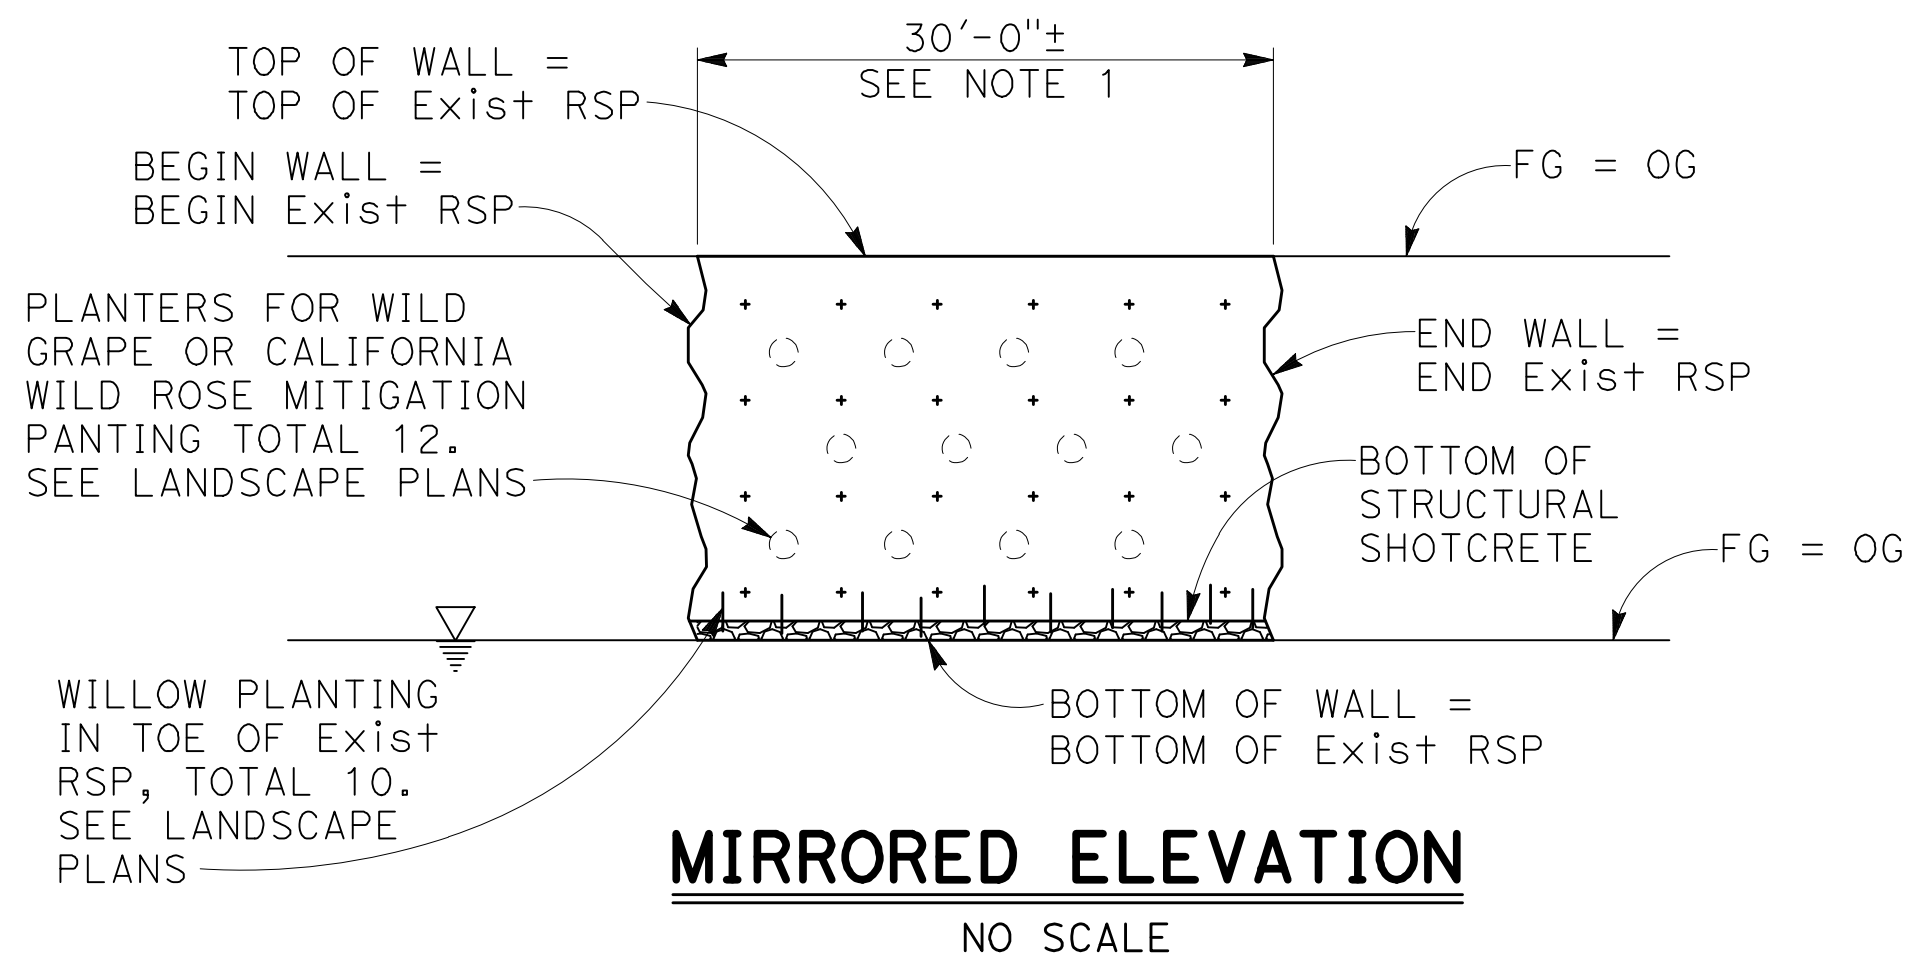


LEGEND:

- ⇒ Indicates Traffic Direction
- + Indicates soil nail assembly location
- ▽ Indicates water surface elevation at time of construction
- Direction of creek flow

NOTES:

1. The existing RSP limits are approximate since as-built plans are not available and may vary in the field from what is shown
2. Verify locations of existing utilities and protect in place. Notify the Engineer if the soil nails do not provide a minimum clearance of 3'-0" around the existing utilities.
3. Bottom of Shotcrete to be 1'-0" above creek water surface elevation at time of construction.

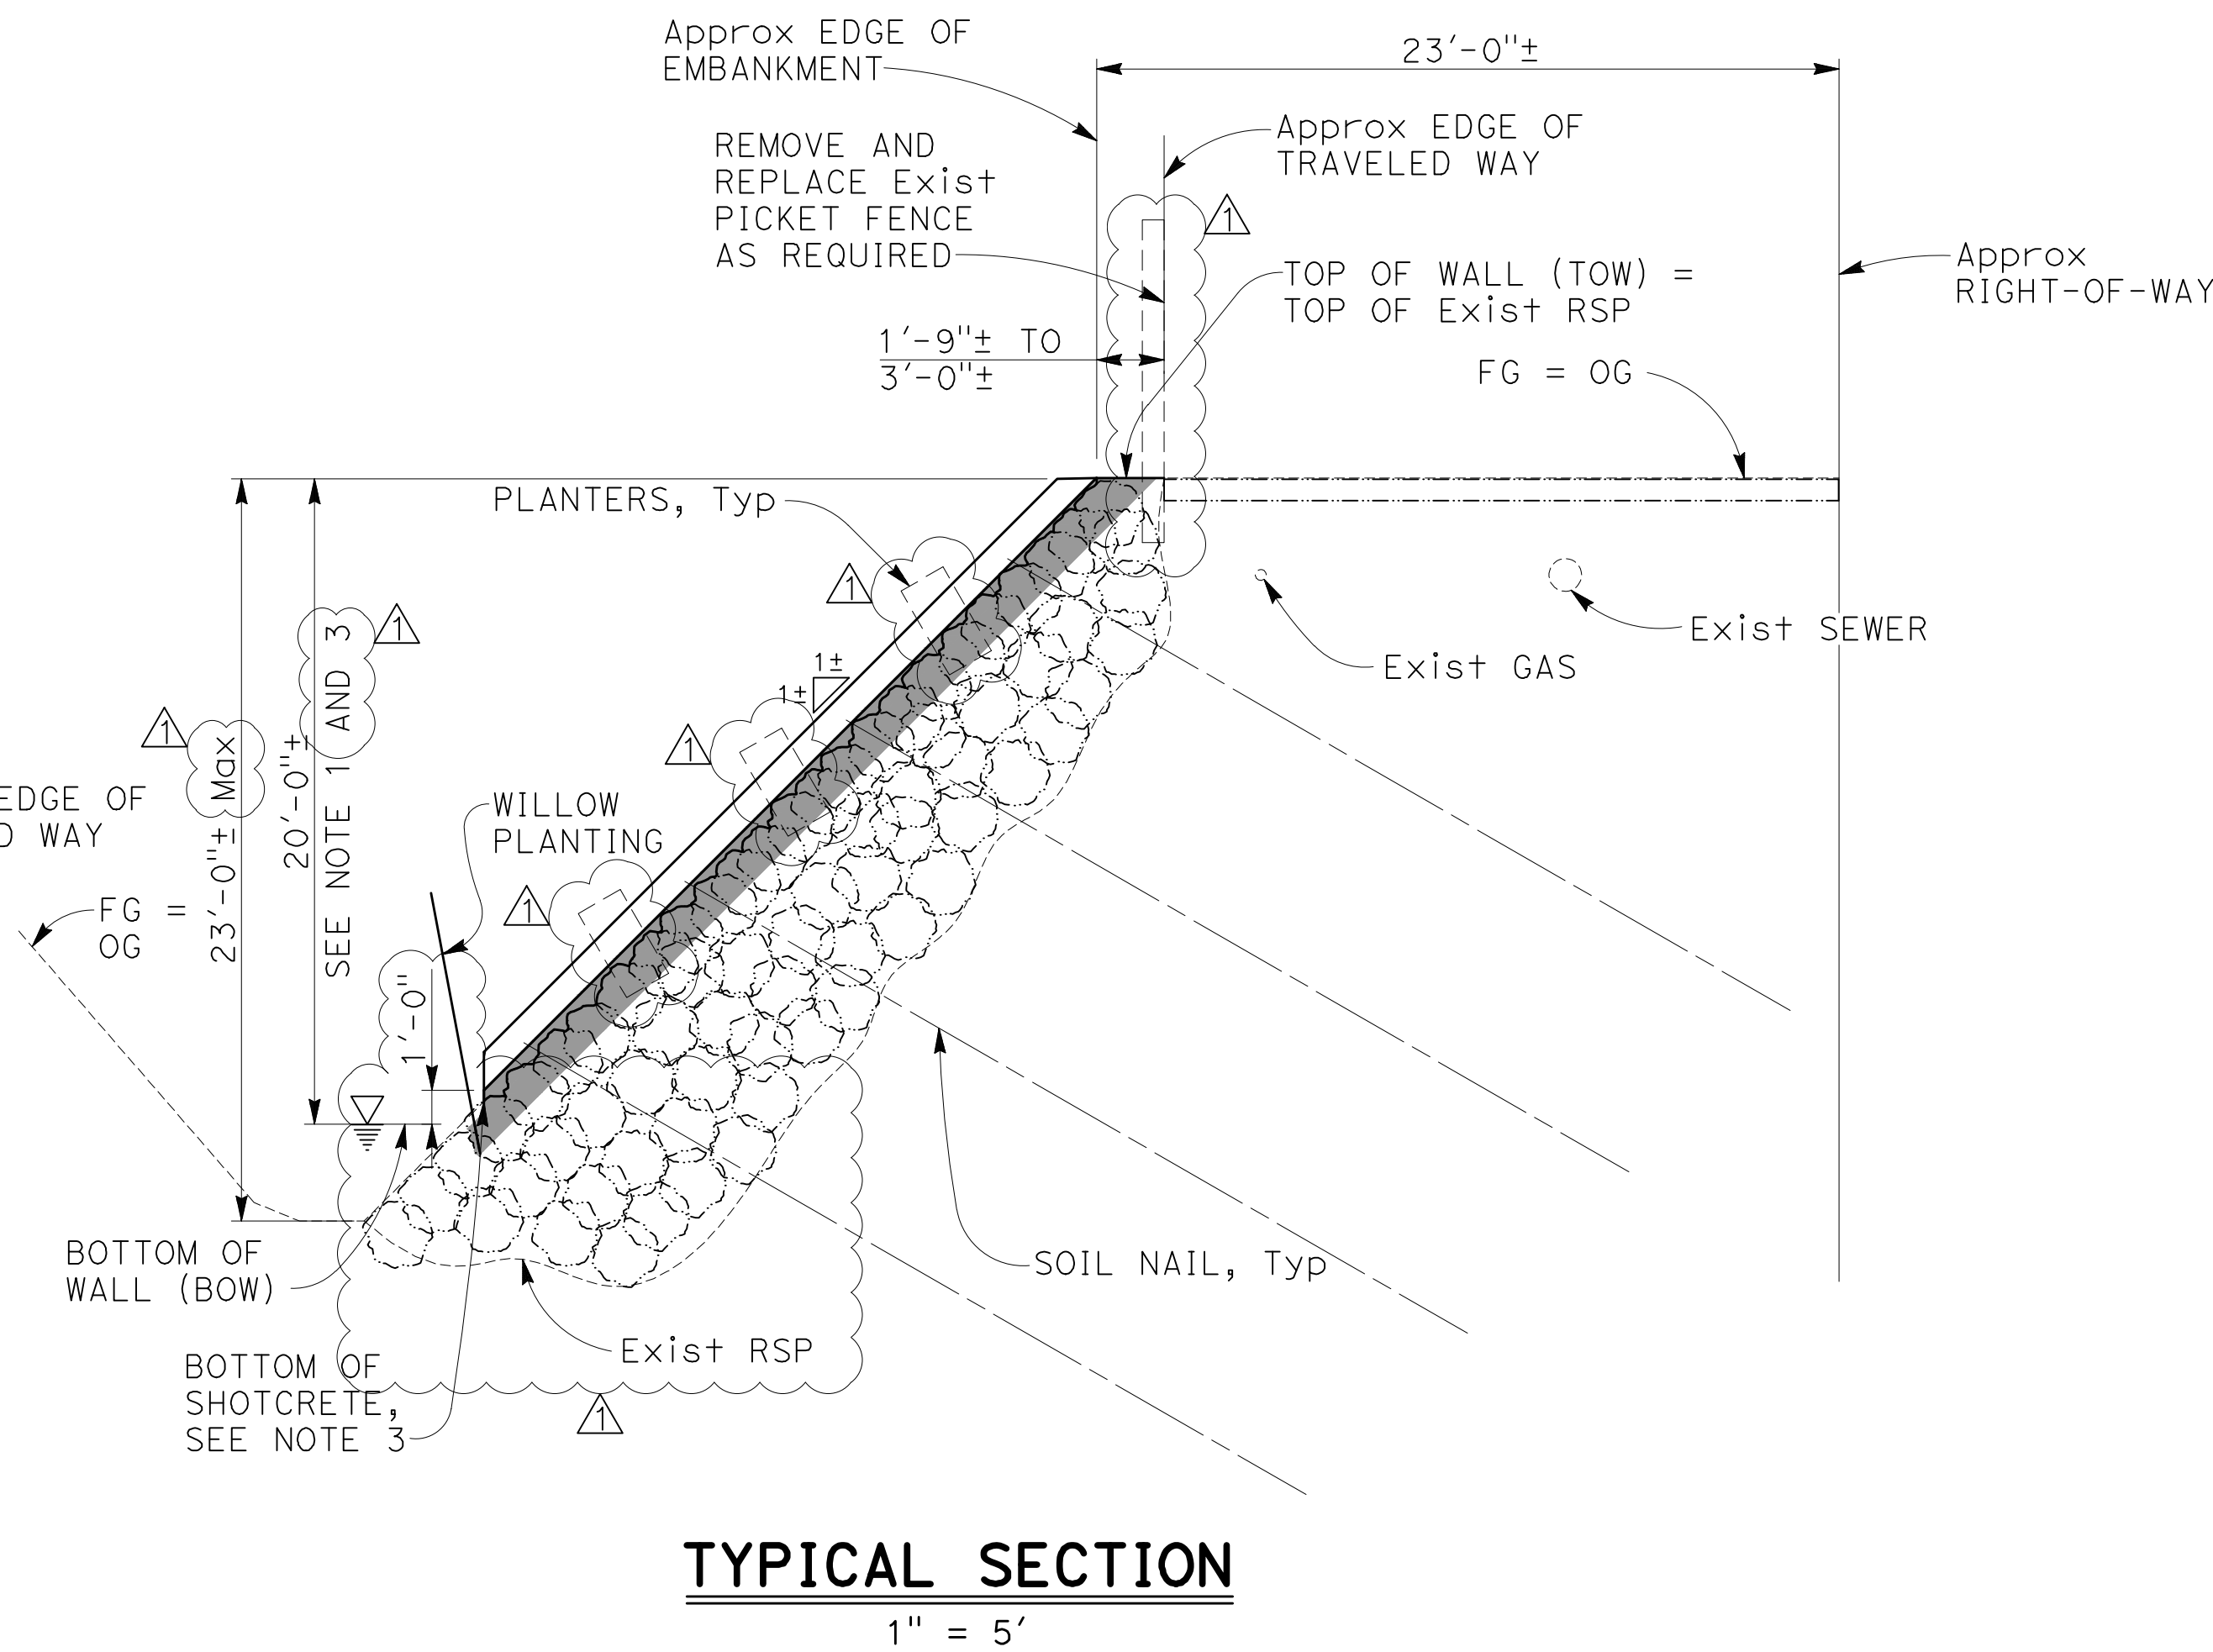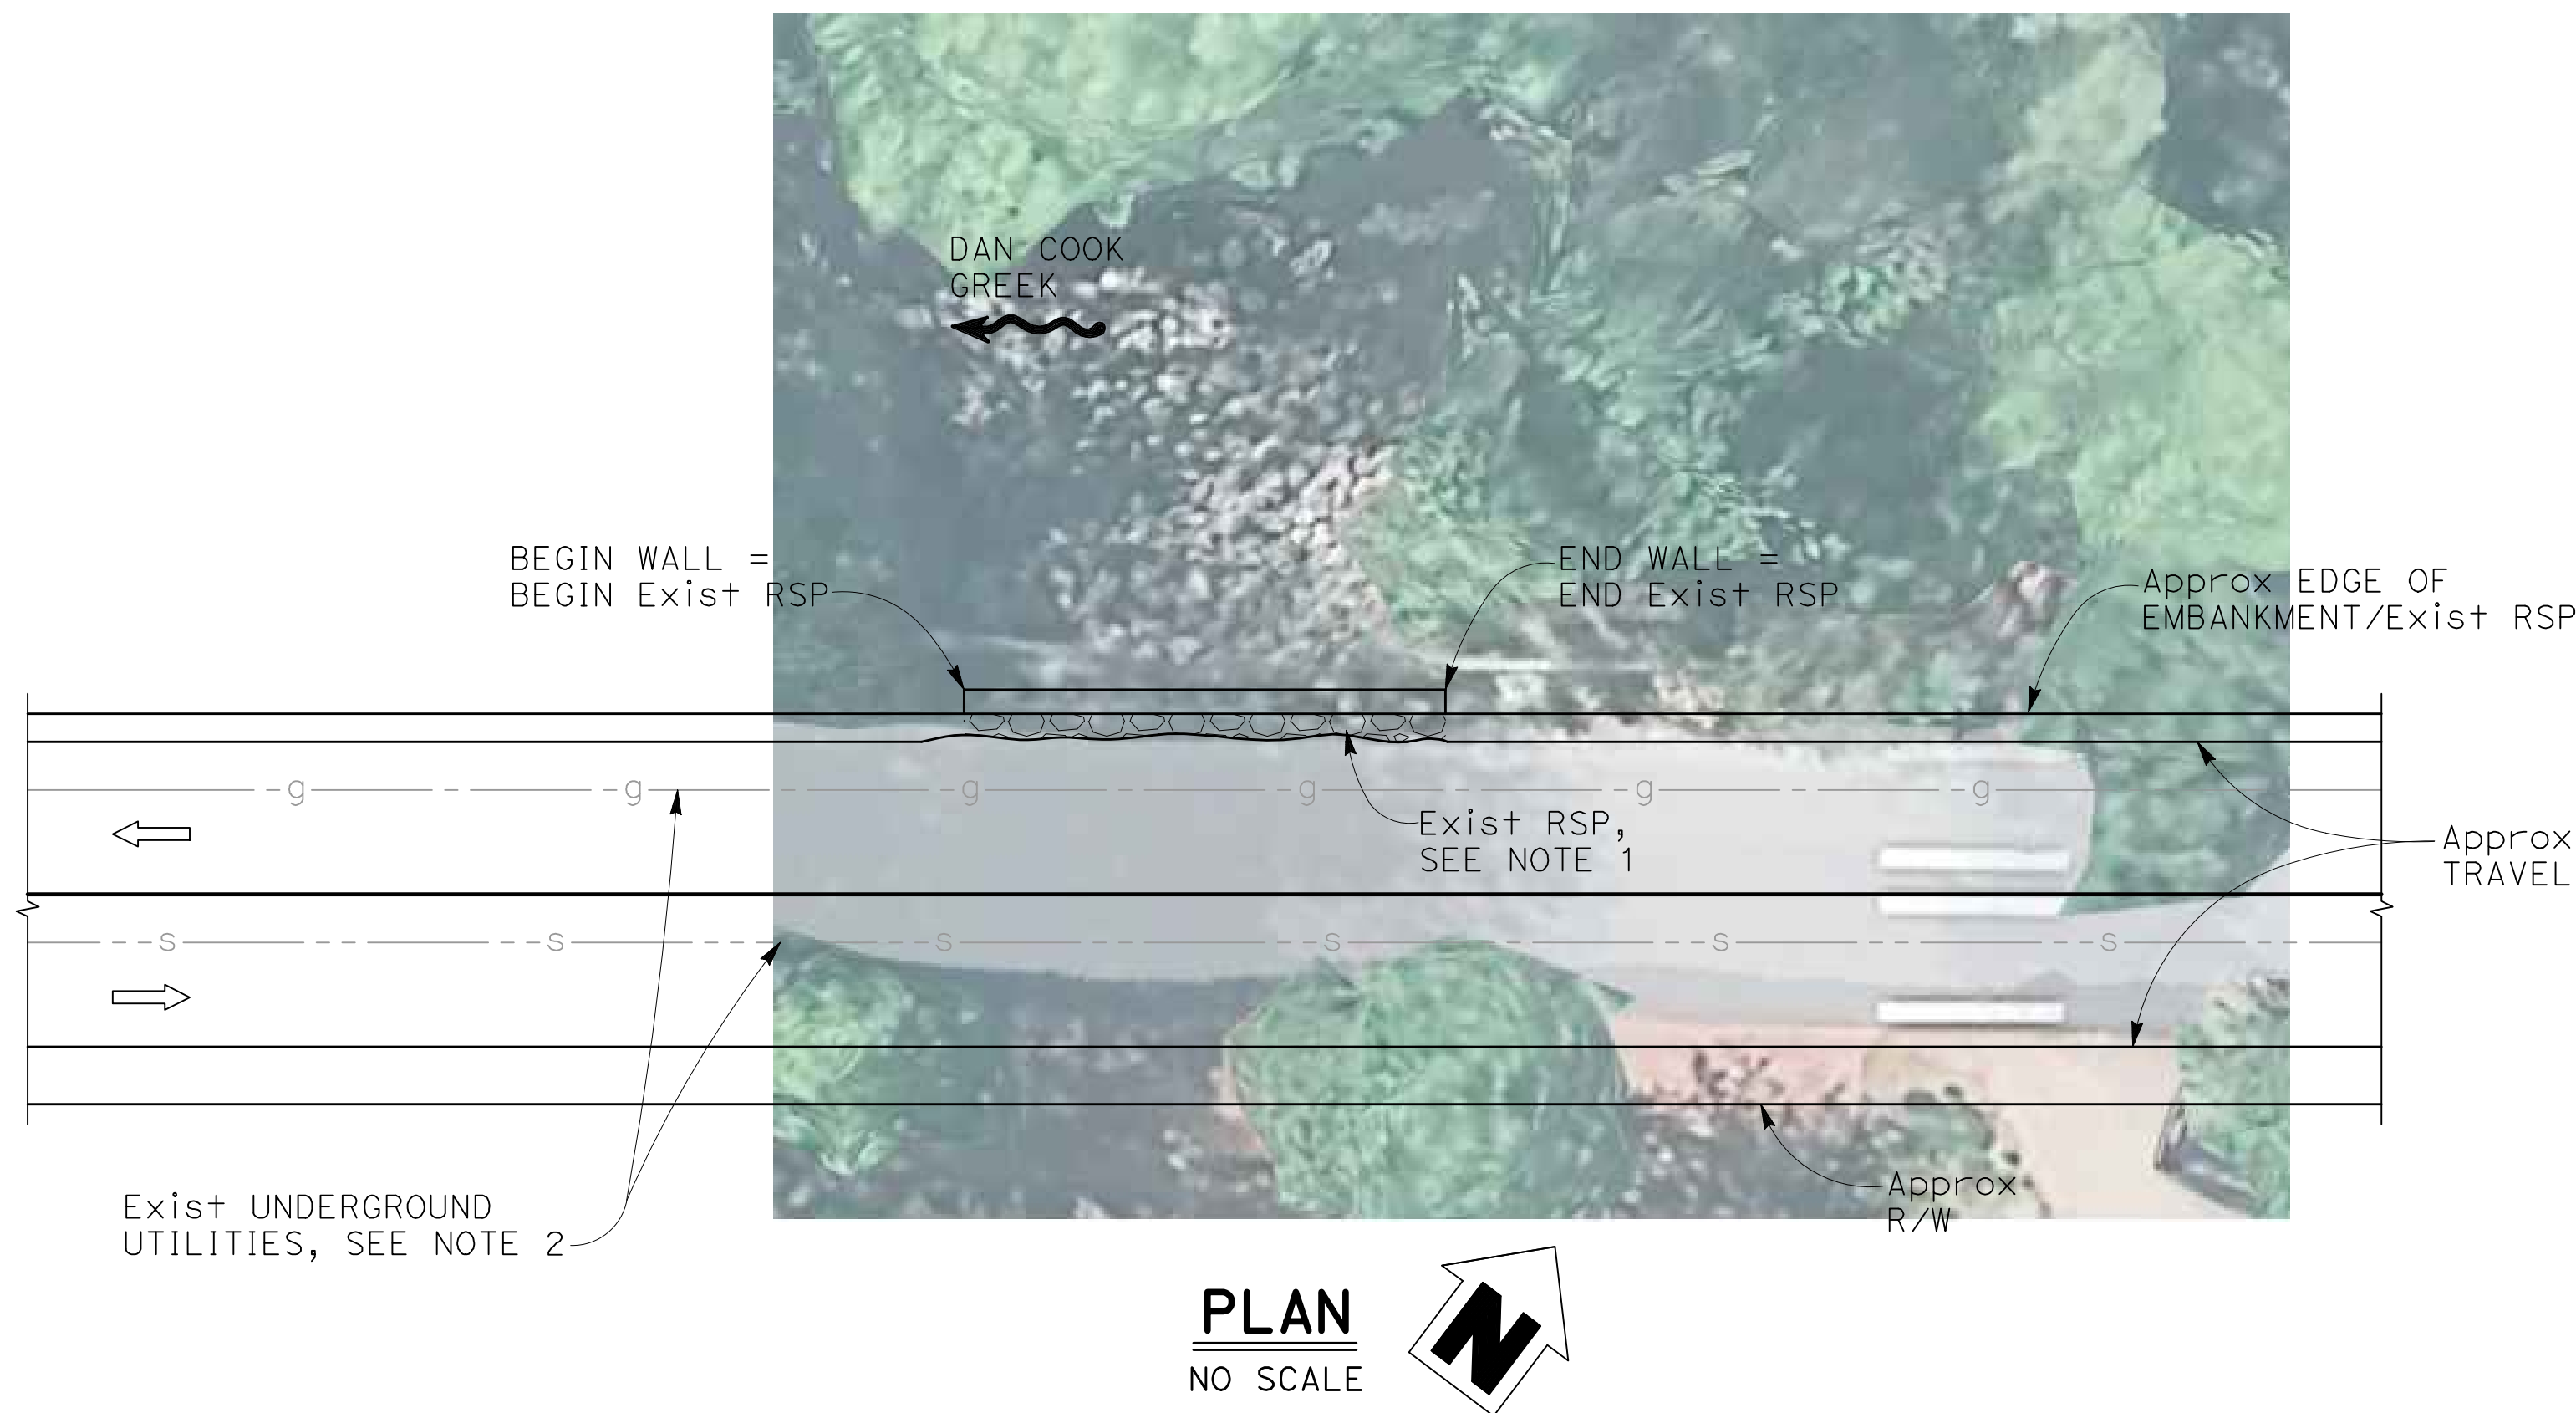

IF THERE ARE ANY DIFFERENCES BETWEEN THE MOST CURRENT SIGNED DOCUMENTS AND EARLIER OR UNSIGNED VERSIONS OF THE DOCUMENTS, THE MOST CURRENT SIGNED DOCUMENTS SHALL GOVERN. BIGGS CARDOSA IS NOT RESPONSIBLE FOR ANY MODIFICATIONS MADE TO OUR DOCUMENTS BY ANYONE OTHER THAN THE ENGINEER OF RECORD FOR BIGGS CARDOSA

NOTE:
THE CONTRACTOR MUST VERIFY ALL CONTROLLING FIELD DIMENSIONS BEFORE ORDERING OR FABRICATING ANY MATERIAL

DESIGNED BY:
A. CORDOVA

DRAWN BY:
F. OJEDA

CHECKED BY:
I. LI

SCALE:
AS SHOWN

REV

DATE

DESCRIPTION

865 The Alameda
San Jose, CA 95126
T. 408.296.5515
www.biggs-cardosa.com

BIGGS CARDOSA

GENERAL PLAN

2121 ALAMEDA DIABLO AVENUE
CREEK EMBANKMENT STABILIZATION

DIABLO
CALIFORNIA

SHEET NUMBER
S-1
4 OF 9 SHEETS

DRAWING NO.
2026301-4

PROFESSIONAL ENGINEER
REGISTERED
No. 48345
Exp. 9/30/27
STATE OF CALIFORNIA
CIVIL

2026301-1


FILL VOIDS IN Exist RSP
WITH MINOR CONCRETE TO STABILIZE
RSP TO PROVIDE BASE SURFACE
FOR STRUCTURAL SHOTCRETE.
PLACE CONCRETE TO A Min
DEPTH OF 10" FROM OUTER
LOW (ROCK) POINT SURFACE
OF Exist RSP. SEE (4)
(5-4)

LEGEND:

- + Indicates soil nail assembly location
- ⊕ Indicates proof test soil nail location.
Location may be adjusted by the Engineer
- L_E Indicates soil nail embedment length along
soil nail


NOTES:

1. The existing RSP limits are approximate (since as-built plans are not available) and may vary in the field from what is shown. Notify the Engineer if the limits of RSP require soil nail spacings beyond the max and min for Sv and Sh
2. Horizontal Drain Pipe must be 15'-0" long. 10'-0" of the pipe will be slotted and 5'-0" will be unslotted.
3. Bottom of Structural Shotcrete to be 1'-0" above (creek water surface elevation at time of construction).

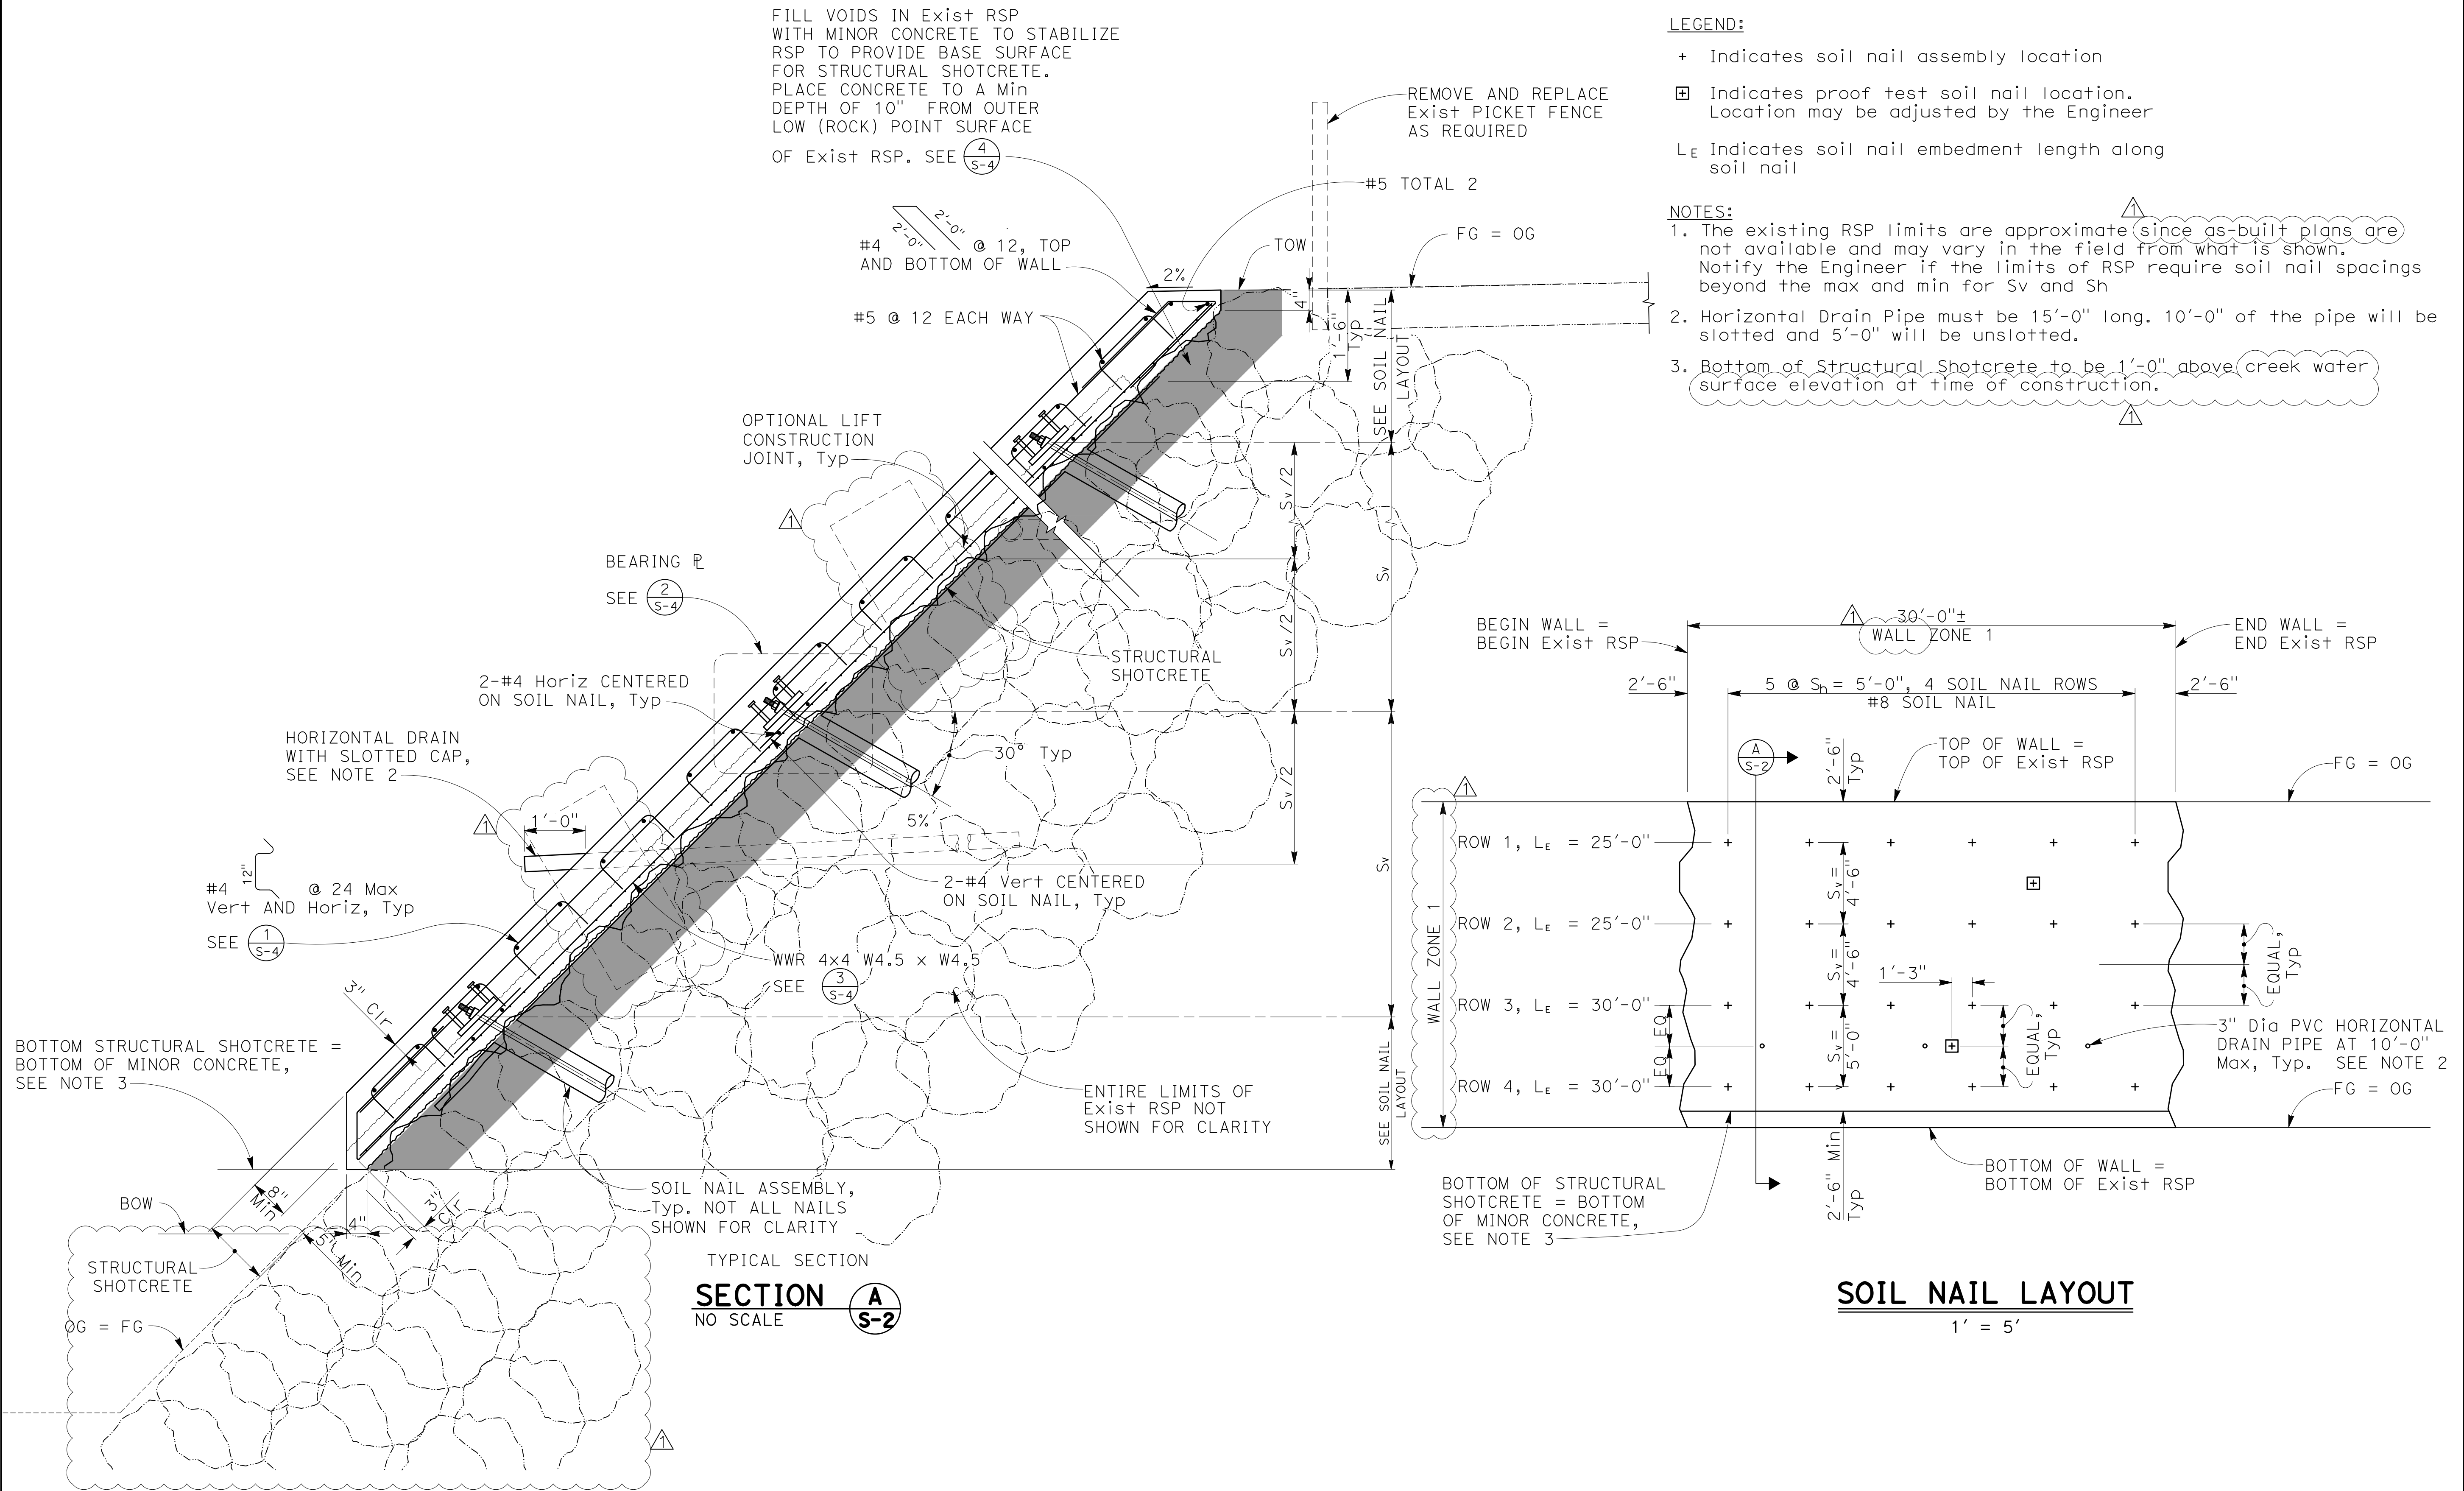

IF THERE ARE ANY DIFFERENCES BETWEEN THE MOST CURRENT SIGNED DOCUMENTS AND EARLIER OR UNSIGNED VERSIONS OF THE DOCUMENTS, THE MOST CURRENT SIGNED DOCUMENTS SHALL GOVERN. BIGGS CARDOSA IS NOT RESPONSIBLE FOR ANY MODIFICATIONS MADE TO OUR DOCUMENTS BY ANYONE OTHER THAN THE ENGINEER OF RECORD FOR BIGGS CARDOSA

NOTE:
THE CONTRACTOR MUST VERIFY ALL
CONTROLLING FIELD DIMENSIONS BEFORE
ORDERING OR FABRICATING ANY MATERIAL

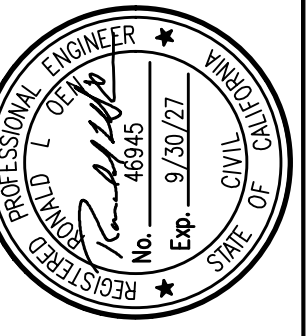

A. CORDOVA
DRAWN BY: F. OJEDA
CHECKED BY: I. LI
SCALE: AS SHOWN

[illegible]

--	--	--	--	--	--	--	--	--

--	--	--	--	--	--	--	--	--

[illegible][illegible]

ADDENDUM _____

ISSUED FOR _____

[illegible][illegible]da
5126
osa.co

lamed
CA 91
5515
scard

The A
Jose,
08.296
w.bigg

865 San T. 400 www

USA



BIG

JE
TION
FORNIA

VENUE
LIZARD
CALIFORNIA

OUT
LO A
STAB

LAYER 3: DIABETES PREVENTION

- NAIL
EDA I
VKMISOIL
LAMIN
MBAI

21 A
EK E


21
CRE
DIABLO

SHEET NUMBER

S-2

5 OF 9 SHEETS
DRAWING NO. 2026301-5

2026301

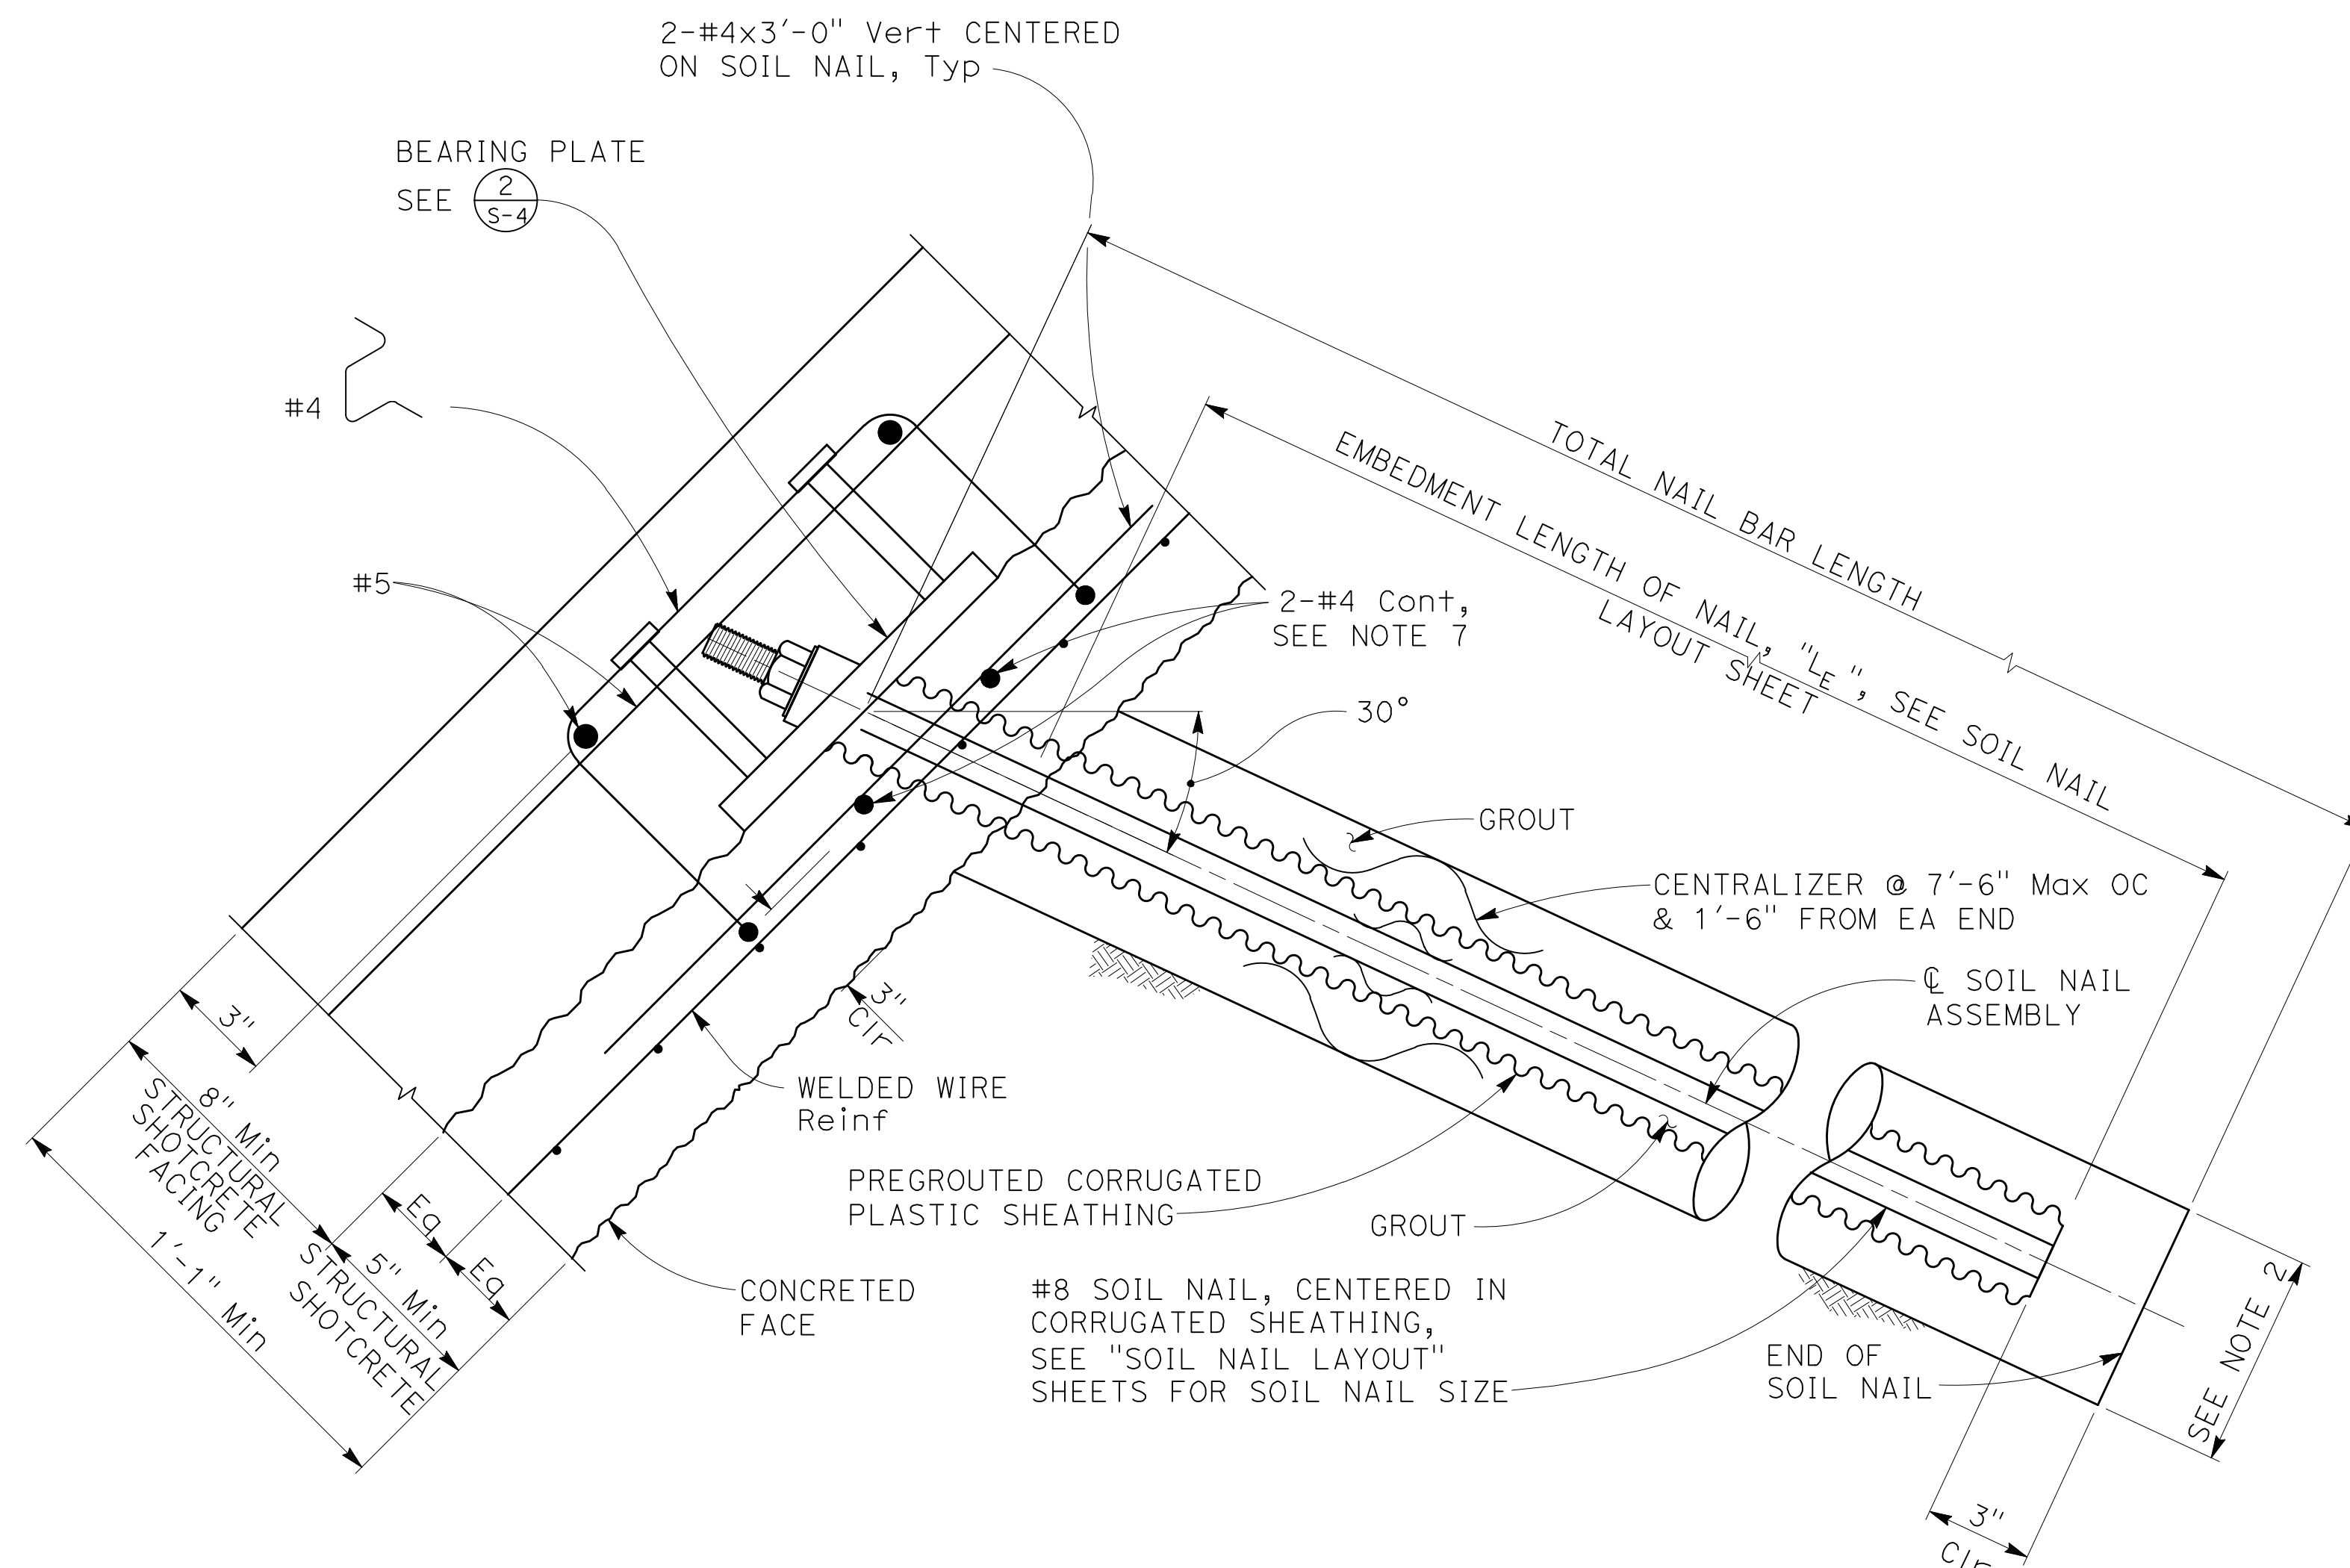

BEARING PLATE
SEE 

#4 

#5—

TEST NO.	TEST DATE	TEST TIME	TEST LOCATION	TEST TYPE	TEST RESULT	TEST COMMENTS
1	10/10/2018	10:00	10101	EMBEDMENT LENGTH OF NAIL	1.5	1.5
2	10/10/2018	10:05	10101	EMBEDMENT LENGTH OF NAIL	1.5	1.5
3	10/10/2018	10:10	10101	EMBEDMENT LENGTH OF NAIL	1.5	1.5
4	10/10/2018	10:15	10101	EMBEDMENT LENGTH OF NAIL	1.5	1.5
5	10/10/2018	10:20	10101	EMBEDMENT LENGTH OF NAIL	1.5	1.5
6	10/10/2018	10:25	10101	EMBEDMENT LENGTH OF NAIL	1.5	1.5
7	10/10/2018	10:30	10101	EMBEDMENT LENGTH OF NAIL	1.5	1.5
8	10/10/2018	10:35	10101	EMBEDMENT LENGTH OF NAIL	1.5	1.5
9	10/10/2018	10:40	10101	EMBEDMENT LENGTH OF NAIL	1.5	1.5
10	10/10/2018	10:45	10101	EMBEDMENT LENGTH OF NAIL	1.5	1.5
11	10/10/2018	10:50	10101	EMBEDMENT LENGTH OF NAIL	1.5	1.5
12	10/10/2018	10:55	10101	EMBEDMENT LENGTH OF NAIL	1.5	1.5
13	10/10/2018	11:00	10101	EMBEDMENT LENGTH OF NAIL	1.5	1.5
14	10/10/2018	11:05	10101	EMBEDMENT LENGTH OF NAIL	1.5	1.5
15	10/10/2018	11:10	10101	EMBEDMENT LENGTH OF NAIL	1.5	1.5
16	10/10/2018	11:15	10101	EMBEDMENT LENGTH OF NAIL	1.5	1.5
17	10/10/2018	11:20	10101	EMBEDMENT LENGTH OF NAIL	1.5	1.5
18	10/10/2018	11:25	10101	EMBEDMENT LENGTH OF NAIL	1.5	1.5
19	10/10/2018	11:30	10101	EMBEDMENT LENGTH OF NAIL	1.5	1.5
20	10/10/2018	11:35	10101	EMBEDMENT LENGTH OF NAIL	1.5	1.5
21	10/10/2018	11:40	10101	EMBEDMENT LENGTH OF NAIL	1.5	1.5
22	10/10/2018	11:45	10101	EMBEDMENT LENGTH OF NAIL	1.5	1.5
23	10/10/2018	11:50	10101	EMBEDMENT LENGTH OF NAIL	1.5	1.5
24	10/10/2018	11:55	10101	EMBEDMENT LENGTH OF NAIL	1.5	1.5
25	10/10/2018	12:00	10101	EMBEDMENT LENGTH OF NAIL	1.5	1.5
40	10/10/2018	1:15	10101	EMBEDMENT LENGTH OF NAIL	1.5	1.5
41	10/10/2018	1:20	10101	EMBEDMENT LENGTH OF NAIL	1.5	1.5
42	10/10/2018	1:25	10101	EMBEDMENT LENGTH OF NAIL	1.5	1.5
43	10/10/2018	1:30	10101	EMBEDMENT LENGTH OF NAIL	1.5	1.5
44	10/10/2018	1:35	10101	EMBEDMENT LENGTH OF NAIL	1.5	1.5
45	10/10/2018	1:40	10101	EMBEDMENT LENGTH OF NAIL	1.5	1.5
46	10/10/2018	1:45	10101	EMBEDMENT LENGTH OF NAIL	1.5	1.5
47	10/10/2018	1:50	10101	EMBEDMENT LENGTH OF NAIL	1.5	1.5
48	10/10/2018	1:55	10101	EMBEDMENT LENGTH OF NAIL	1.5	1.5
4						

— 30°

-#4 Cont,
F NOTE 7

 30°

- GROUT

-CENTRALIZER @ 7'-6" Max OC
& 1'-6" FROM EA END

SOIL NAIL ASSEMBLY

WELDED WIRE
Reinfc

PREGROUTED CORRUGATED
PLASTIC SHEATHING

GROUT

CONCRETE
FACE

#8 SOIL NAIL, CENTERED IN
CORRUGATED SHEATHING,
SEE "SOIL NAIL LAYOUT"
SHEETS FOR SOIL NAIL SIZE-

END OF
SOIL NAIL

SEE NOTE

3"

C/F

NOTE: RSP AND MINOR CONCRETE FILL NOT SHOWN

SOIL NAIL ASSEMBLY

$$3'' = 1' - 0''$$

- NOTES:
1. For Vert and Horiz soil nail spacing, see "SOIL NAIL LAYOUT" sheet.
 2. The diameter of drilled hole will be determined by Contractor. Min drilled hole diameter is 6".
 3. The test nail assembly length L_{ET} must be equal to $\frac{2}{3}$ of the embedment length, L_E , of adjacent production soil nail assemblies, but not less than 12'-0".
 4. The total length of the test nail assembly equals the embedment length plus the length required for jacking equipment.
 5. For location of proof test nail see "SOIL NAIL LAYOUT" sheet. Additional proof test nails will be installed and tested per special provisions.
 6. Finished grout surface to be normal to soil nail.
 7. Extend #4 bar 3 feet each side beyond soil nails at discontinuities in level of soil nails.

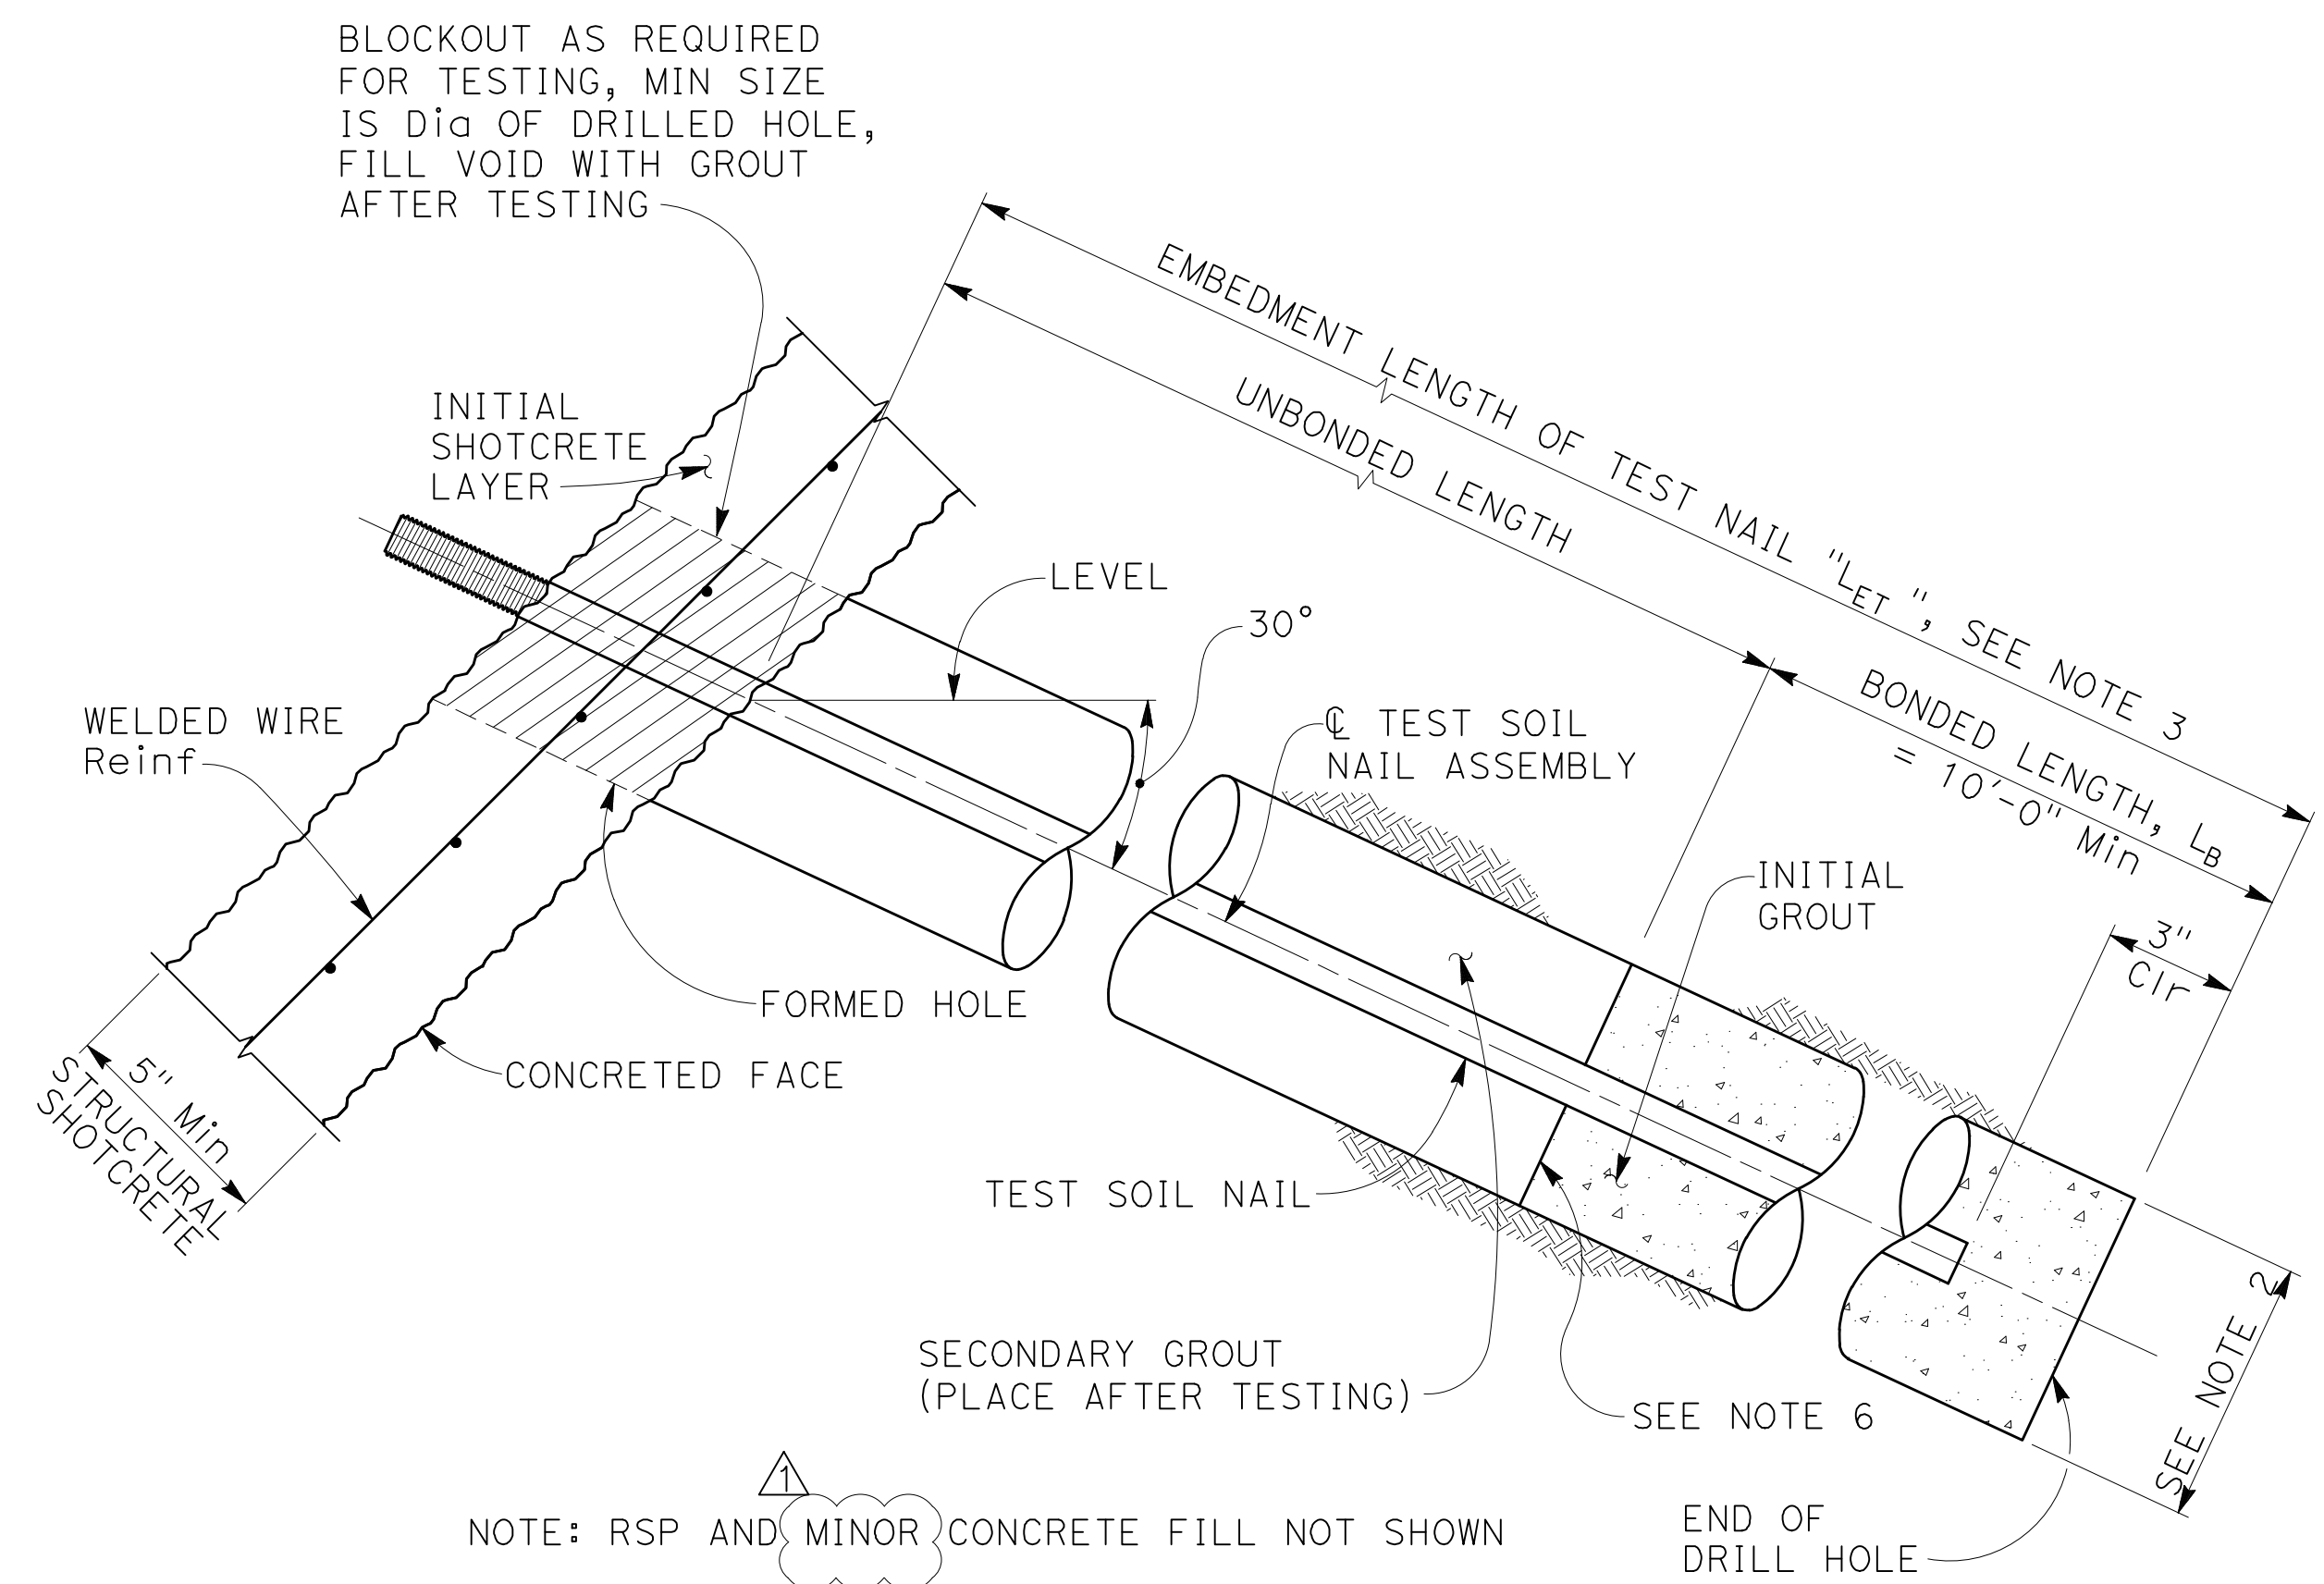


Diagram illustrating the components of a concrete-lined channel cross-section:

- CONCRETED FACE (Bottom)
- FORM (Sloped sides)

TEST SOIL NAIL-

SECONDARY GROUT
(PLACE AFTER TESTING)

END OF
DRILL HO

SEE NOTE 6.

LENGTH OF
UNBONDED LENGTH

SEE NOTE 3
BONDED LENGTH,
= 10'-0" MIN.

2

TE


NOTE: RSP AND MINOR CONCRETE FILL NOT SHOWN

TEST SOIL NAIL ASSEMBLY

$$3'' = 1' - 0''$$

IF THERE ARE ANY DIFFERENCES BETWEEN THE MOST CURRENT SIGNED DOCUMENTS AND EARLIER OR UNSIGNED VERSIONS OF THE DOCUMENTS, THE MOST CURRENT SIGNED DOCUMENTS SHALL GOVERN. BIGGS CARDOSA IS NOT RESPONSIBLE FOR ANY MODIFICATIONS MADE TO OUR DOCUMENTS BY ANYONE OTHER THAN THE ENGINEER OF RECORD

NOTE:
THE CONTRACTOR MUST VERIFY ALL
CONTROLLING FIELD DIMENSIONS BEFORE
ORDERING OR FABRICATING ANY MATERIAL

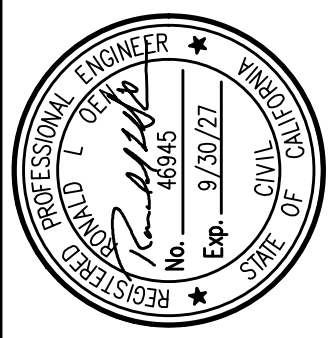

DESIGNED BY: A. CORDOVA	DRAWN BY: F. OJEDA	CHECKED BY: I. LI	SCALE: AS SHOWN
----------------------------	-----------------------	----------------------	--------------------

[illegible]

865 The Alameda
San Jose, CA 95126
T. 408.296.5515
www.biggscardosa.com



SOIL NAIL DETAILS No. 1	2121 ALAMEDA DIABLO AVENUE CREEK EMBANKMENT STABILIZATION	DIABLO CALIFORNIA
-------------------------	--	----------------------

SHEET NUMBER
S-3
6 OF 9 SHEETS
DRAWING NO.
2026301-6



NOTE:
THE CONTRACTOR MUST VERIFY ALL
CONTROLLING FIELD DIMENSIONS BEFORE
ORDERING OR FABRICATING ANY MATERIAL

SHEET NUMBER
S-4
7 OF 9 SHEETS
DRAWING NO.
2026301-7

2026301

GENERAL

<https://dot.ca.gov/programs/design/2025-ccs-standard-plans-and-standard-specifications>

Where applicable, if a reference is made in these special provisions or the Standard Specifications to the "State," the reference shall mean the owner (Diablo Community Services District).

In case of conflict between the Standard Specifications and these special provisions, the special provisions shall take precedence over and be used in lieu of such conflicting provisions.

Dimensions shall take precedence over scales shown on drawings.
Notes and details on drawings shall take precedence over general
notes and typical details.

All work shall conform to the minimum standards of the codes as per project design criteria including the State of California Division of Industrial Safety, and those codes and standards listed in these notes and specifications.

Openings, pockets, etc. larger than 6 inches shall not be placed in unless specifically detailed on the structural drawings.

All construction activities must conform to California Department of Fish and Wildlife (CDFW) 1602 Streambed Alteration Agreement EPIMS-CCA-67273-R3.

IF THERE ARE ANY DIFFERENCES BETWEEN THE MOST CURRENT SIGNED DOCUMENTS AND EARLIER OR UNSIGNED VERSIONS OF THE DOCUMENTS, THE MOST CURRENT SIGNED DOCUMENTS SHALL GOVERN. BIGGS CARDOSA IS NOT RESPONSIBLE FOR ANY MODIFICATIONS MADE TO OUR DOCUMENTS BY ANYONE OTHER THAN THE ENGINEER OF RECORD FOR BIGGS CARDOSA

NOTE:
THE CONTRACTOR MUST VERIFY ALL
CONTROLLING FIELD DIMENSIONS BEFORE
ORDERING OR FABRICATING ANY MATERIAL

1. Seasonal Work Period
2. Work Period in Dry Weather
3. 
4. On-Site Monitoring
5. Daily Inspections

7. Best Management Practices
8. Vegetation Protection

- 11. Erosion and Sediment Control
- 12. Material Handling, Debris, and Waste
- 13. Toxic and Hazardous Waste
- 14. Spills and Emergencies

Structural Shotcrete shall conform to the provisions in Section 53, "Shotcrete" and Section 90-1 of the 2025 Caltrans Standard Specifications.

△ Structural Shotcrete shall have the minimum 28-day compressive strength of 3,600 psi and shall be considered to be designated by compressive strength. The maximum water cement ratio by weight shall be 0.40.

Attention is directed to Sections 15 "Existing Facilities" of the 2025 Caltrans Standard Specifications.

The Contractor shall notify the Engineer (Biggs Cardosa) and the appropriate regional notification center for operators of subsurface installations at least 5 working days, but not more than 14 calendar days, prior to performing any excavation or other work close to any underground pipeline, conduit, duct, wire or other structure. Regional notification centers include but are not limited to the following:

Notification Center	Telephone Number
Underground Service Alert-Northern California (USA)	1-800-642-2444 1-800-227-2600
Underground Service Alert-Southern California (USA)	1-800-422-4133 1-800-227-2600

The Contractor shall pothole prior to the start of construction to verify the location and/or elevation of all underground utility facilities within close proximity to the work, as approved by the Engineer (Biggs Cardosa). All potholing shall completely expose the out-to-out widths of the existing utility, such that the size and lateral extents of the utility can be verified. No potholing shall be performed without a representative of the utility company present at the site. No work shall be performed in the vicinity of said facilities until said facilities have been located.

Minor Concrete for filling voids of existing RSP shall conform to the provisions in Section 72-3 "Concrete-Rock Slope Protection" and Section 90-2 "Minor Concrete" of the 2025 Caltrans Standard Specifications.

Soil nails shall conform to the provisions in Section 46 "Ground Anchors and Soil Nails" of the 2025 Caltrans Standard Specifications.

Expect difficult soil nail installation at the top row of nails due to the presence of existing utilities.

Horizontal drains shall conform to the provisions in Section 68-3 2025 Caltrans Standard Specifications.

Removal and reconstruction of Picket Fence must conform to Section 80 "Fences" of Caltrans Standard Specifications and these technical Specifications.

Submit Fence Product Data for approval prior to fabrication and installation

MOBILIZATION AND CONTRACT PROCESSING COST	1	LS
DIVERSION OF RECYCLABLE WASTE MATERIALS	1	LS
POTHOLE UNDERGROUND UTILITIES	1	LS
TRAFFIC CONTROL SYSTEM	1	LS

SOIL NAIL	723	LF
BAR REINFORCING STEEL (RETAINING WALL)	3080	LB
STRUCTURAL SHOTCRETE	34	CY
MINOR CONCRETE	24	CY
REMOVE PICKET FENCE	50	LF
PICKET FENCE	50	LF
24x24x36 GRFC PLANTERS	12	EA
PLANTER SOIL	40	CY
WILLOW STALKS	10	EA
CALIFORNIA WILD ROSE (1 GALLON)	12	EA
SITE PREPARATION CLEARING AND GRUBBING	1	LS

